



KEY TO SYMBOLS	
	ALARM SOUNDER
	FIRE INDICATOR PANEL
	EMERGENCY LIGHTING
	3 HOUR NON MAINTAINED SMOKE DETECTOR
	HEAT DETECTOR
	CO2 EXTINGUISHER
	FOAM EXTINGUISHER
	WATER EXTINGUISHER
	WET CHEMICAL EXTINGUISHER
	CALL POINT
	FIRE BLANKET
	1/2 HOUR FIRE RESISTANT SELF CLOSING DOOR WITH SMOKE SEALS AND INTUMESCENT STRIPS
	1 HOUR FIRE RESISTANT SELF CLOSING DOOR WITH SMOKE SEALS AND INTUMESCENT STRIPS
	FIRE EXIT DOORS FITTED WITH EMERGENCY PUSH BAR FACILITY
	SIMPLE FASTENING
	VISION PANEL
	SIGN - EMERGENCY EXISTING
	SIGN - EMERGENCY EXIT NOTICE - INDICATES THAT THE NOTICE IS INTERNALLY ILLUMINATED
	SIGN - FIRE DOOR KEEP SHUT
	SIGN - FIRE DOOR KEEP LOCKED
	FIRE ESCAPE ROUTE
	POINT OF CUSTOMER ACCESS
KEY TO AREAS	
	INDICATES EXTENT OF LICENSABLE ACTIVITIES

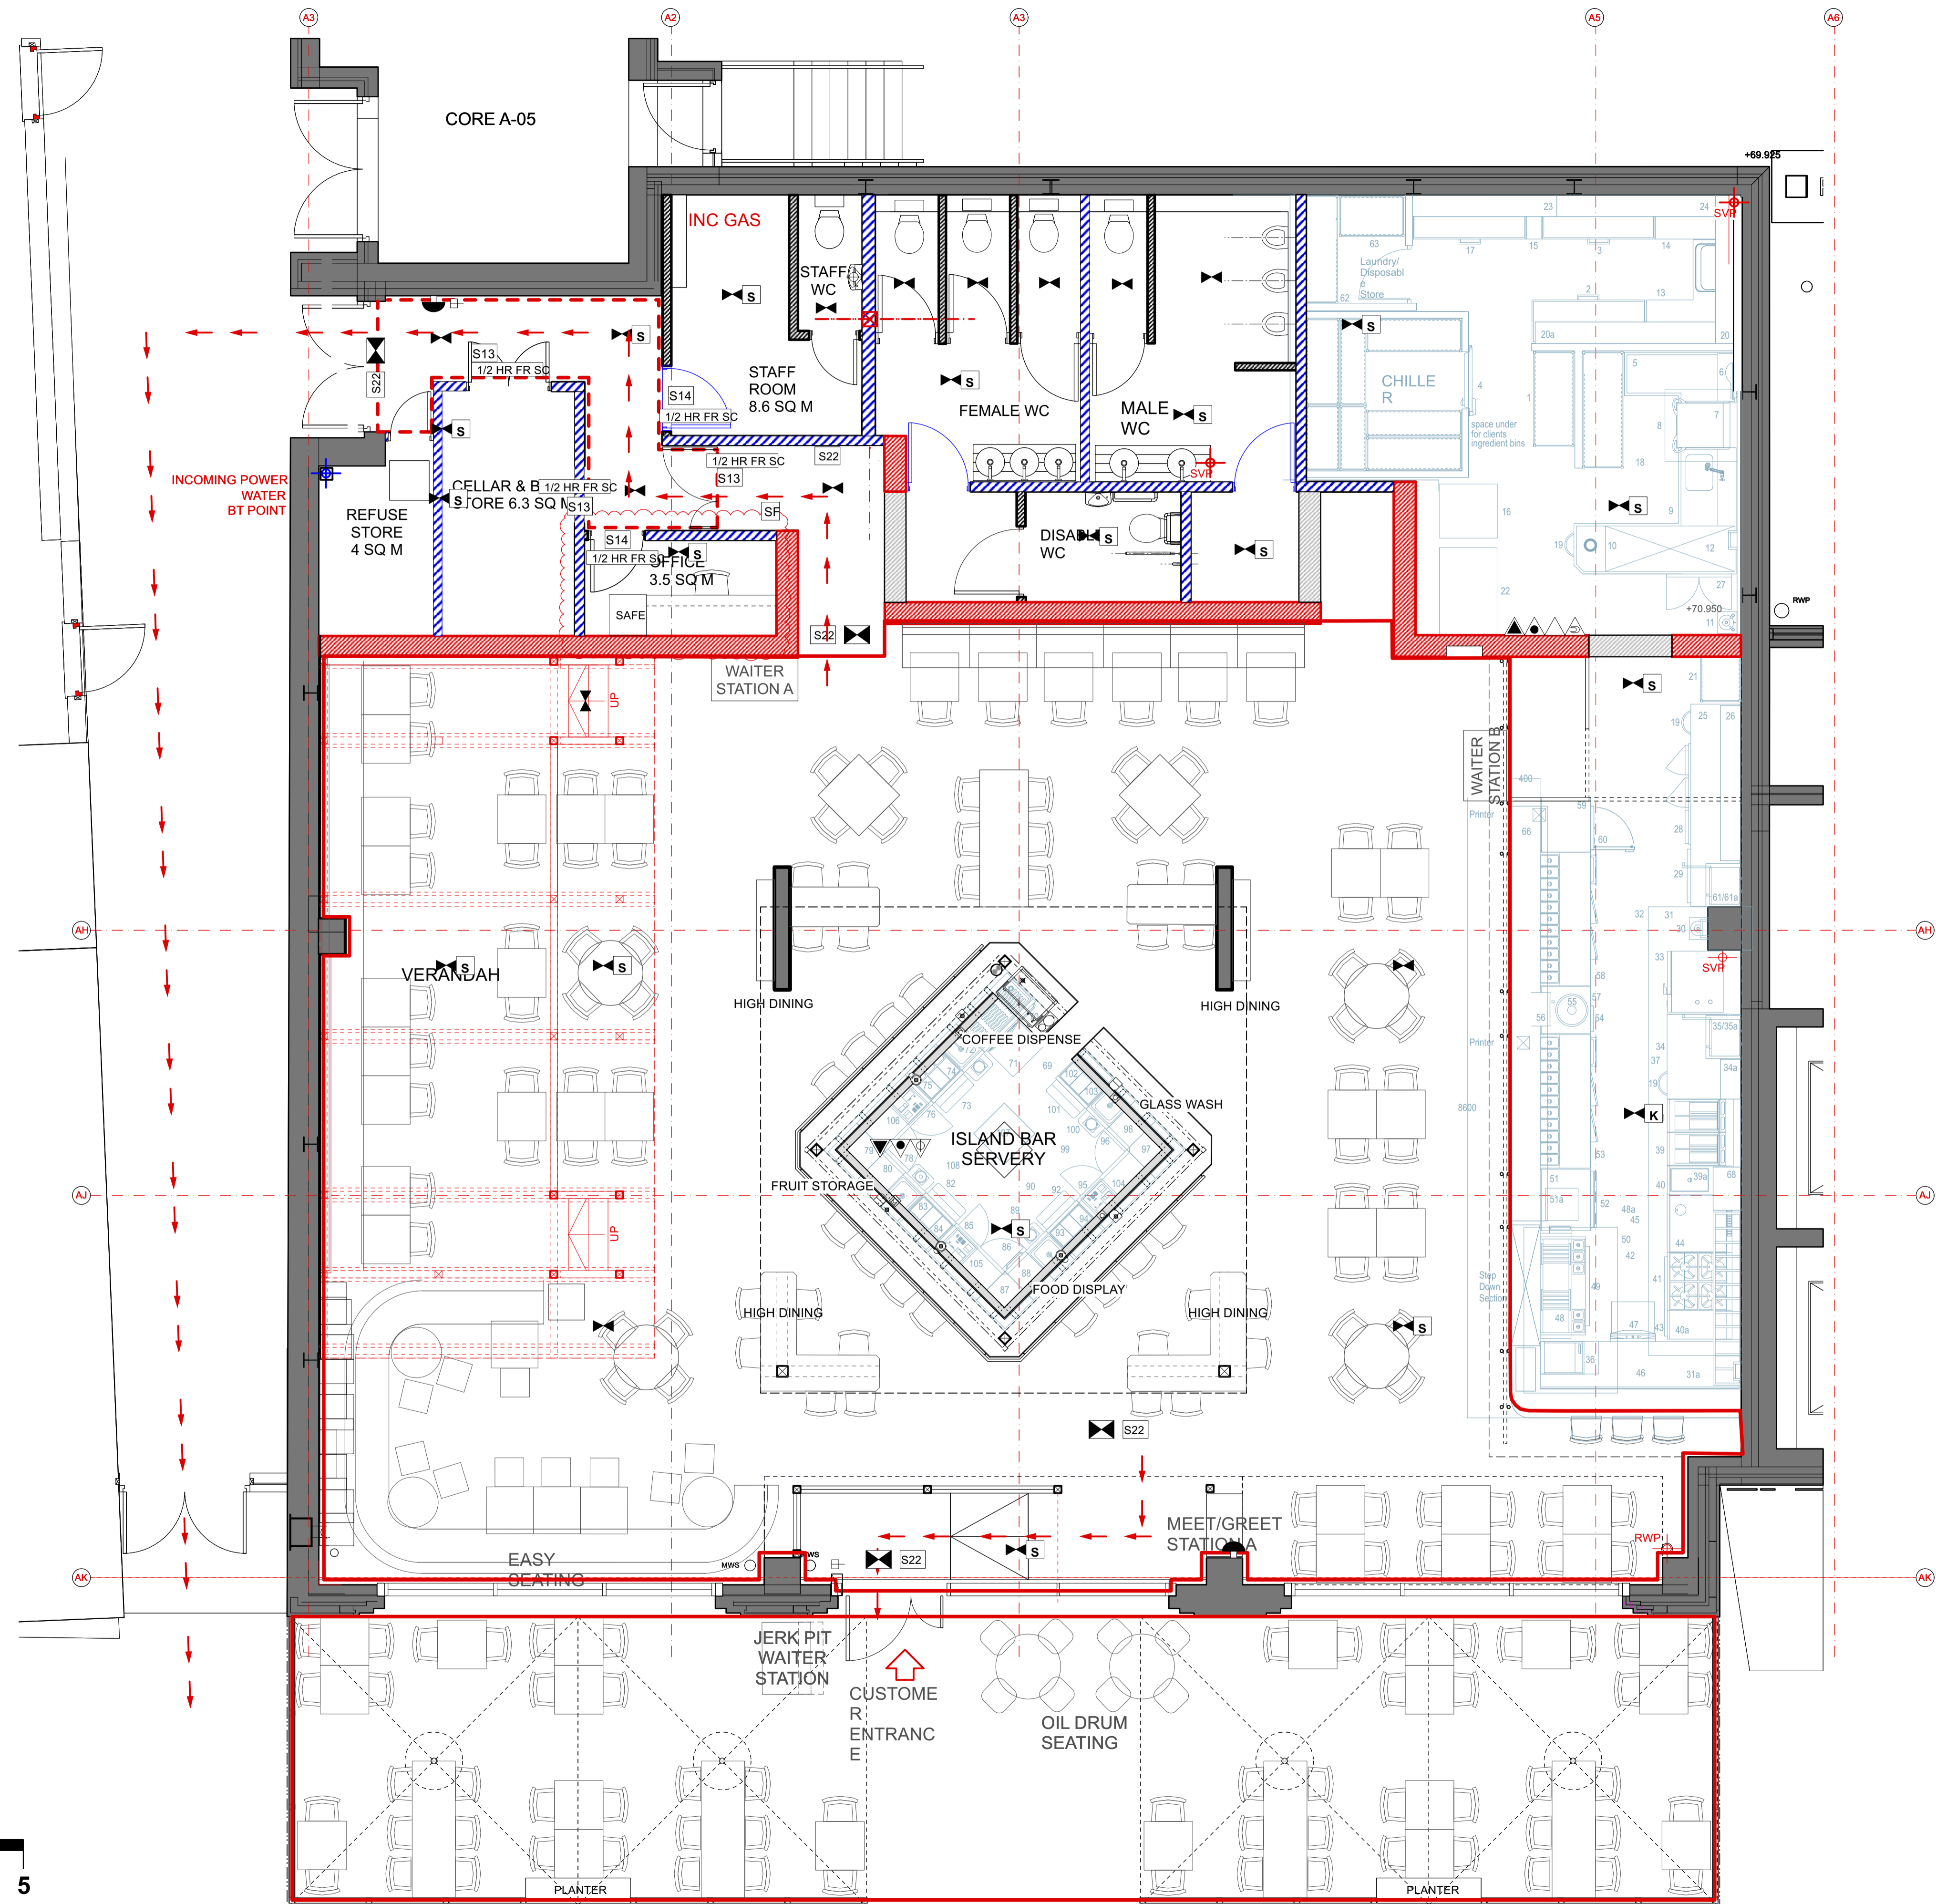

COVERS:	
DINING COVERS -	86
HIGH DINING -	40
EASY SEATING -	24
EXTERNAL	70
TOTAL	220

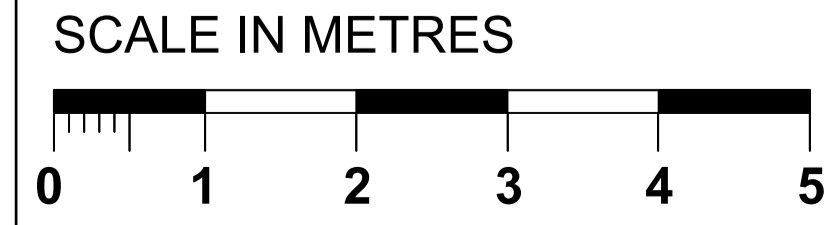

LICENSING PLAN

Notes
 This drawing should not be scaled. The contractor is to verify all dimensions and conditions on site. This drawing is the property of Fusion and they reserve the copyright. It is issued on the understanding that it will not be copied, reproduced or disclosed in whole or in part to any unauthorised party without written permission from Fusion

D 07.08.14 AS BUILT
 C 10.07.14 LICENSING PLAN AMENDED
 B 05.06.14 LAYOUT AMENDED
 A 27.05.14 LAYOUT AMENDED



4 Risborough Street London SE1 0HE
 Tel: 020 7928 9982 Fax: 020 7928 9994
 email: mail@fusiondna.co.uk

Job Name:	TURTLE BAY CRAWLEY
Site Address:	UNIT 1, 100 HIGH STREET CRAWLEY, WEST SUSSEX RH10 1BZ
Dwg Name:	LICENSING LAYOUT
Status:	AS BUILT
Drawn by:	MB
Checked by:	
Scale:	1:50@A1/ 1:100@A3
Date:	JAN 2014
Job/Dwg N°:	110/28-205D